
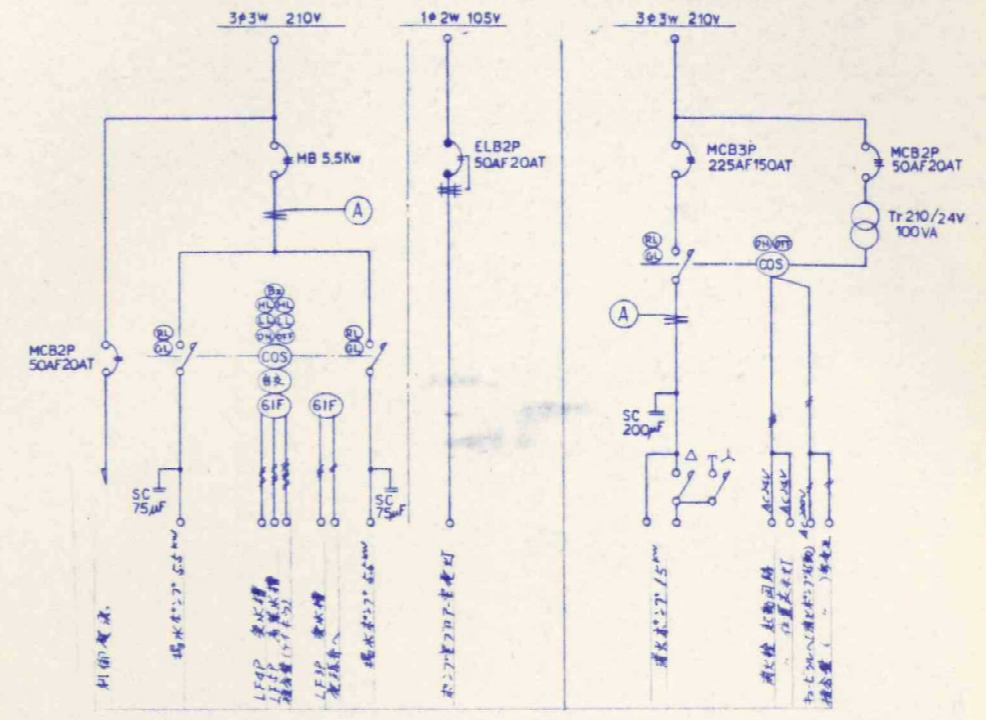


A	CVV 14*13L55E (MIVE 34)	M-1	3P
	65*12C		1P
	CVV 2*14C		1P
	2*14C		1P
	FP-C 32*13L4M	M-1	3P
	65*14C		1P
	CVV 2*14C		1P
			1P


水水槽ポンプ室フロアプラン

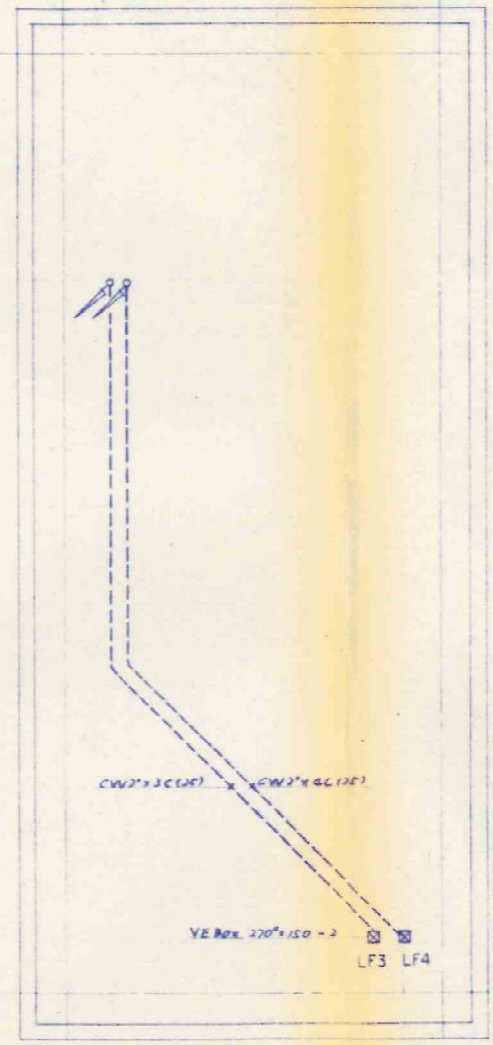

湯水ポンプ盤

消火ポンプ盤

M-1 結線図

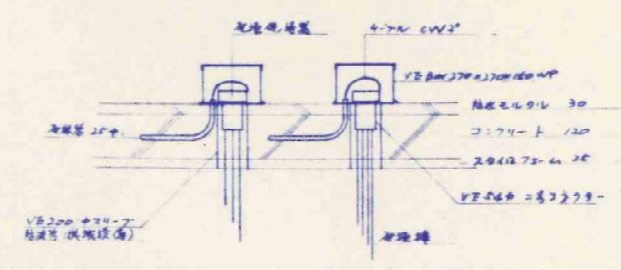

竣工図